



# 計画図 1

## 縮尺 1 : 2,500

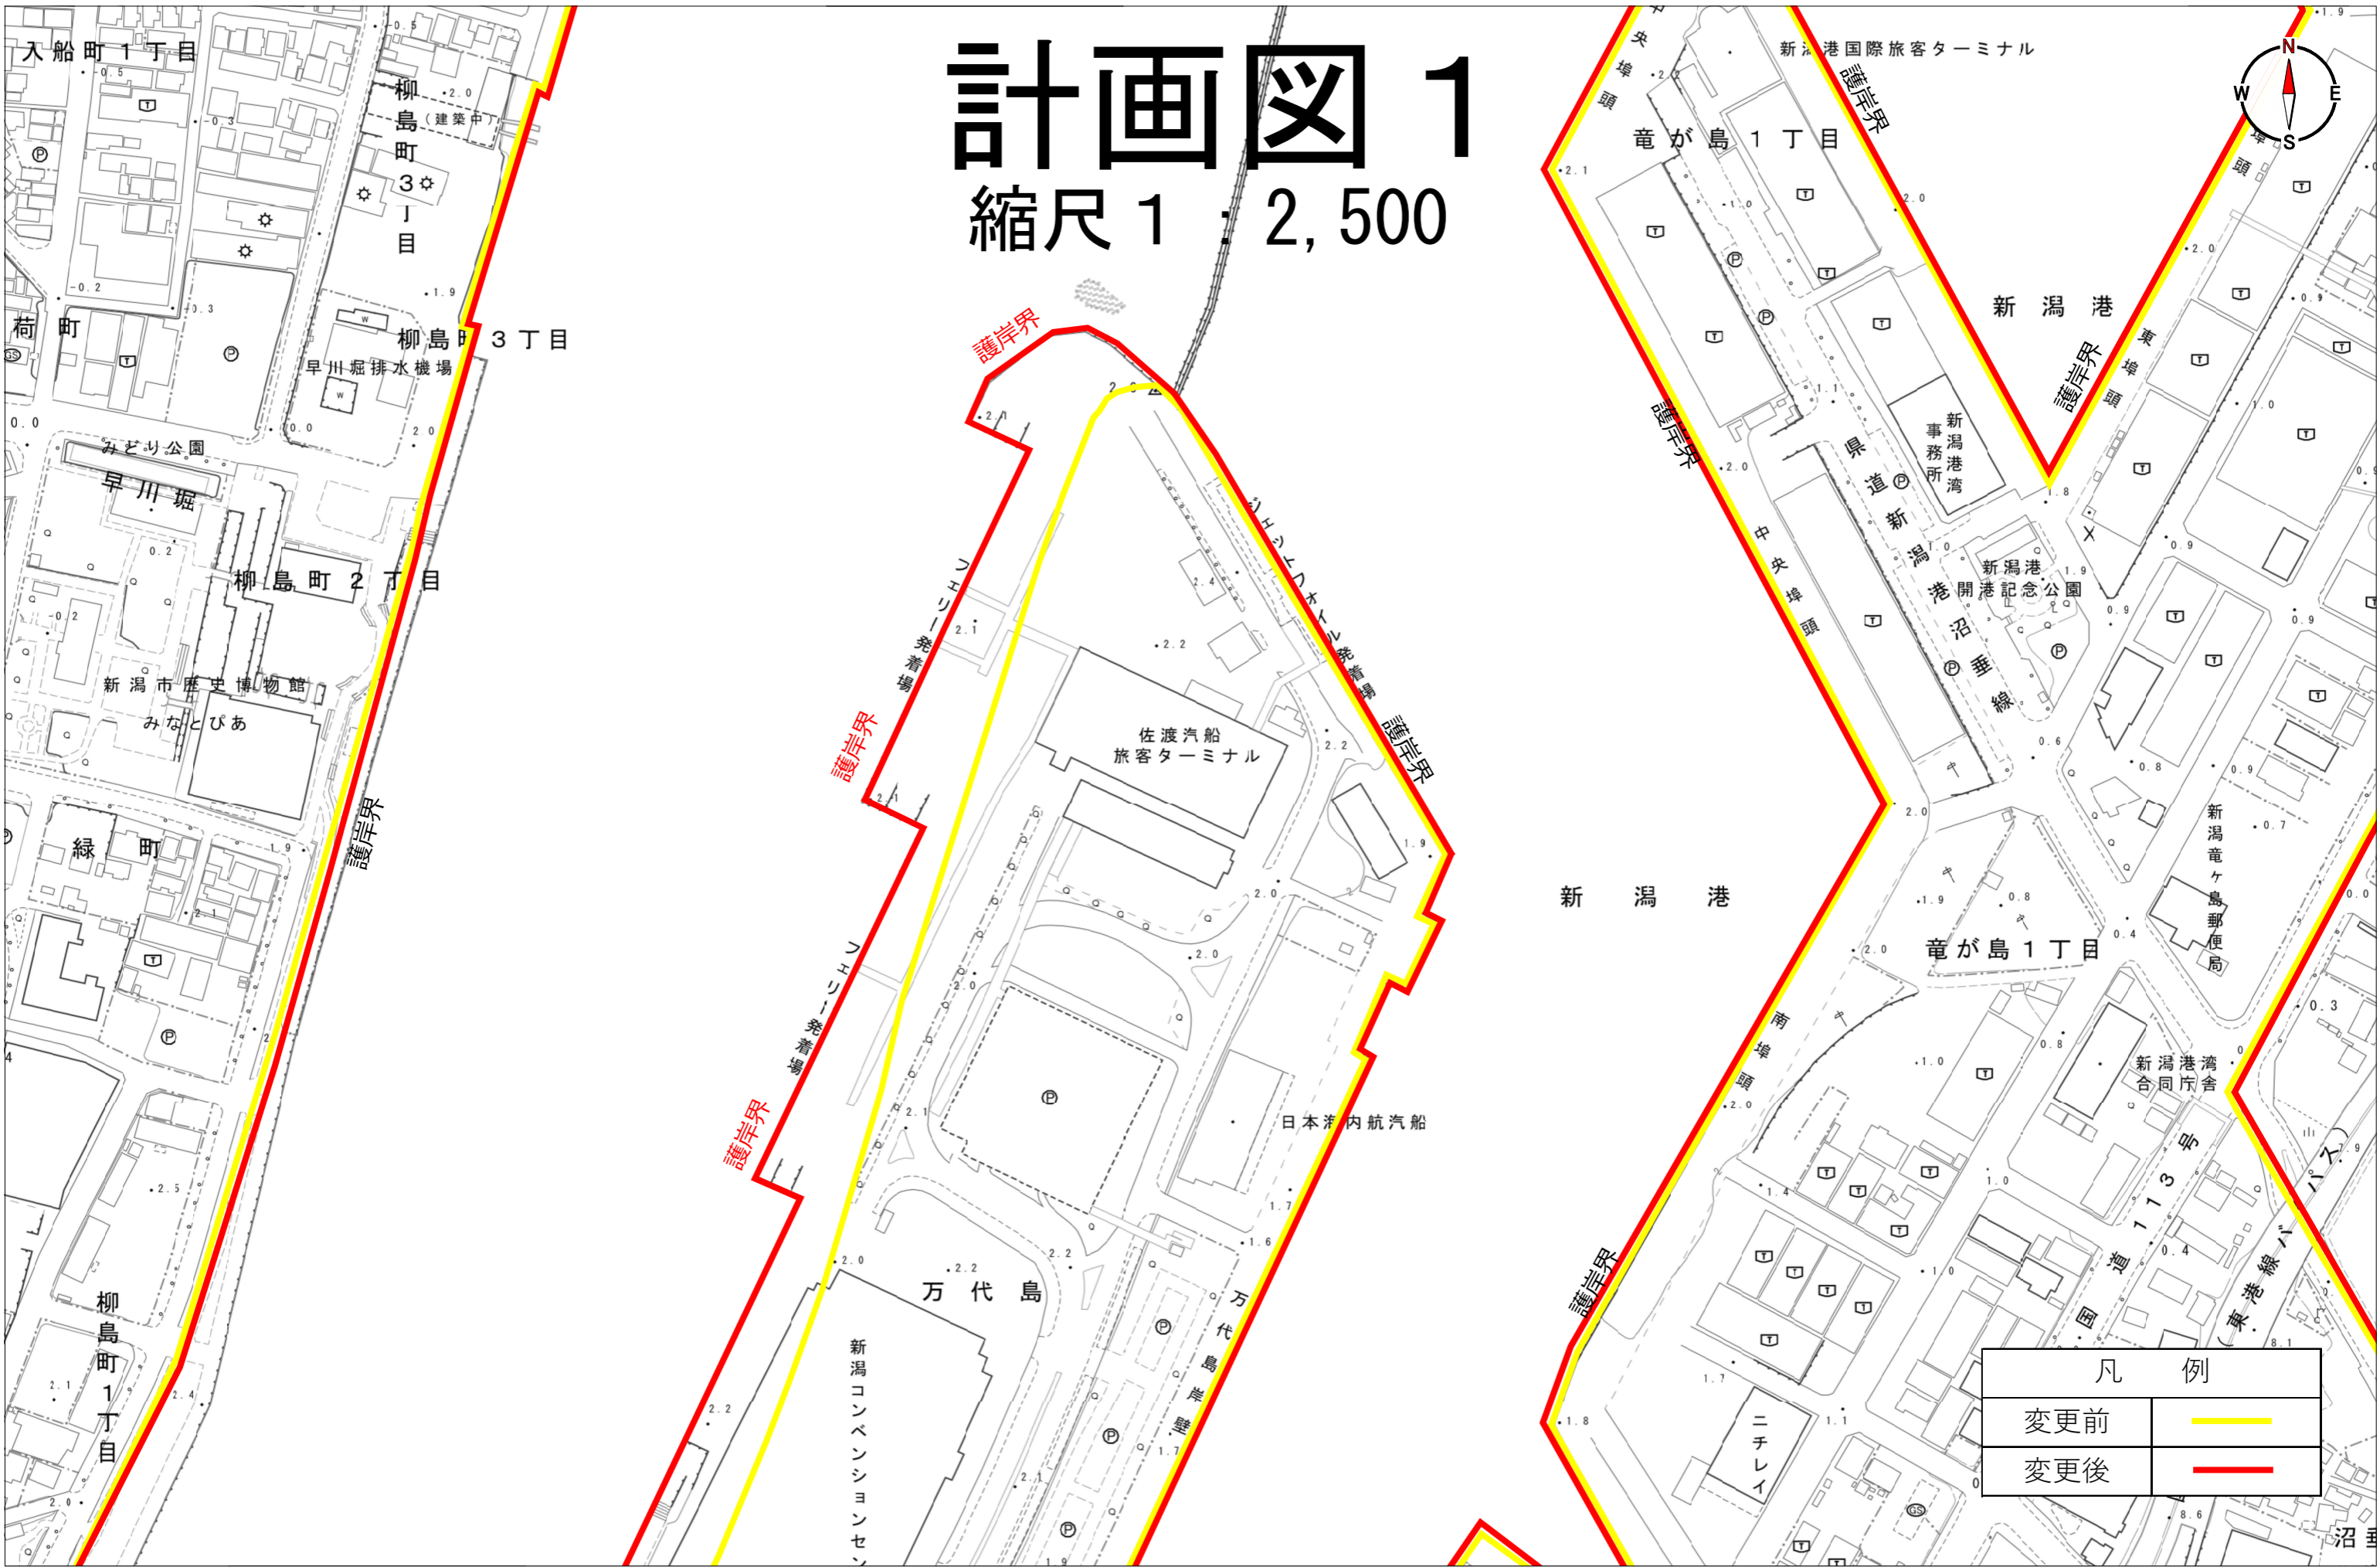

# 計画図2



縮尺 1 : 2,500

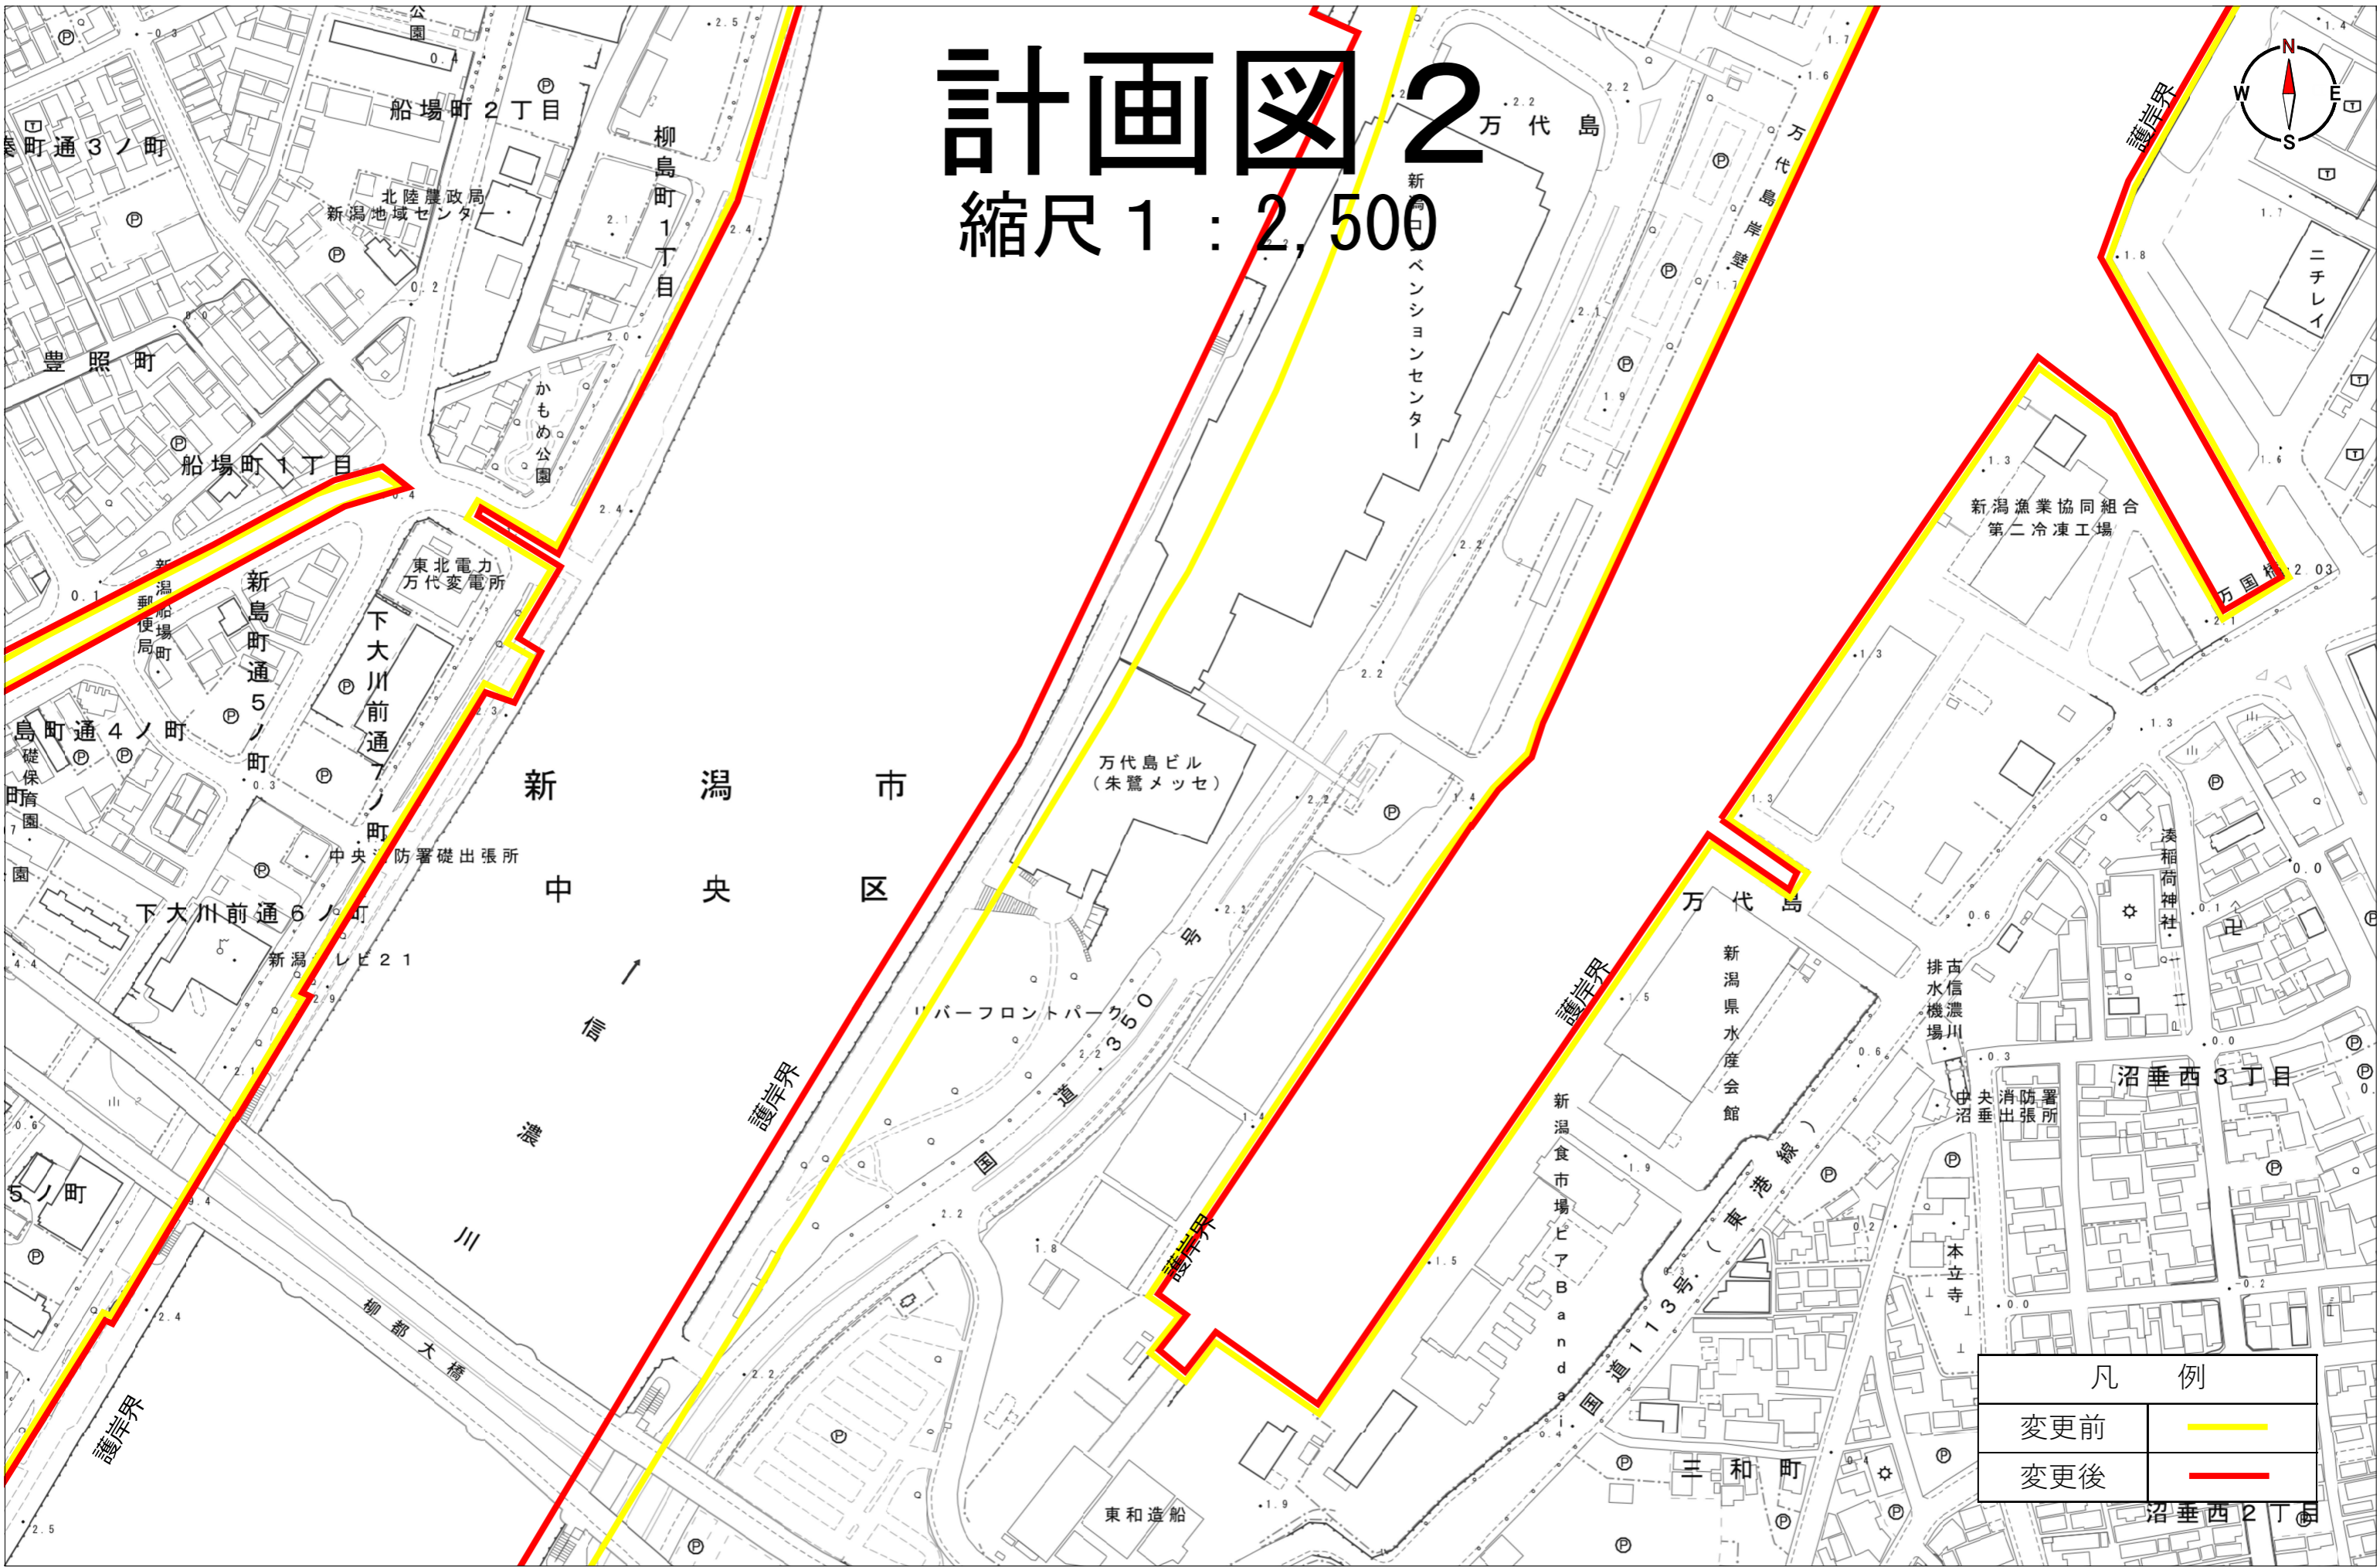

凡例	
变更前	— (Yellow line)
变更后	— (Red line)

# 計画図 3


縮尺 1 : 2,500

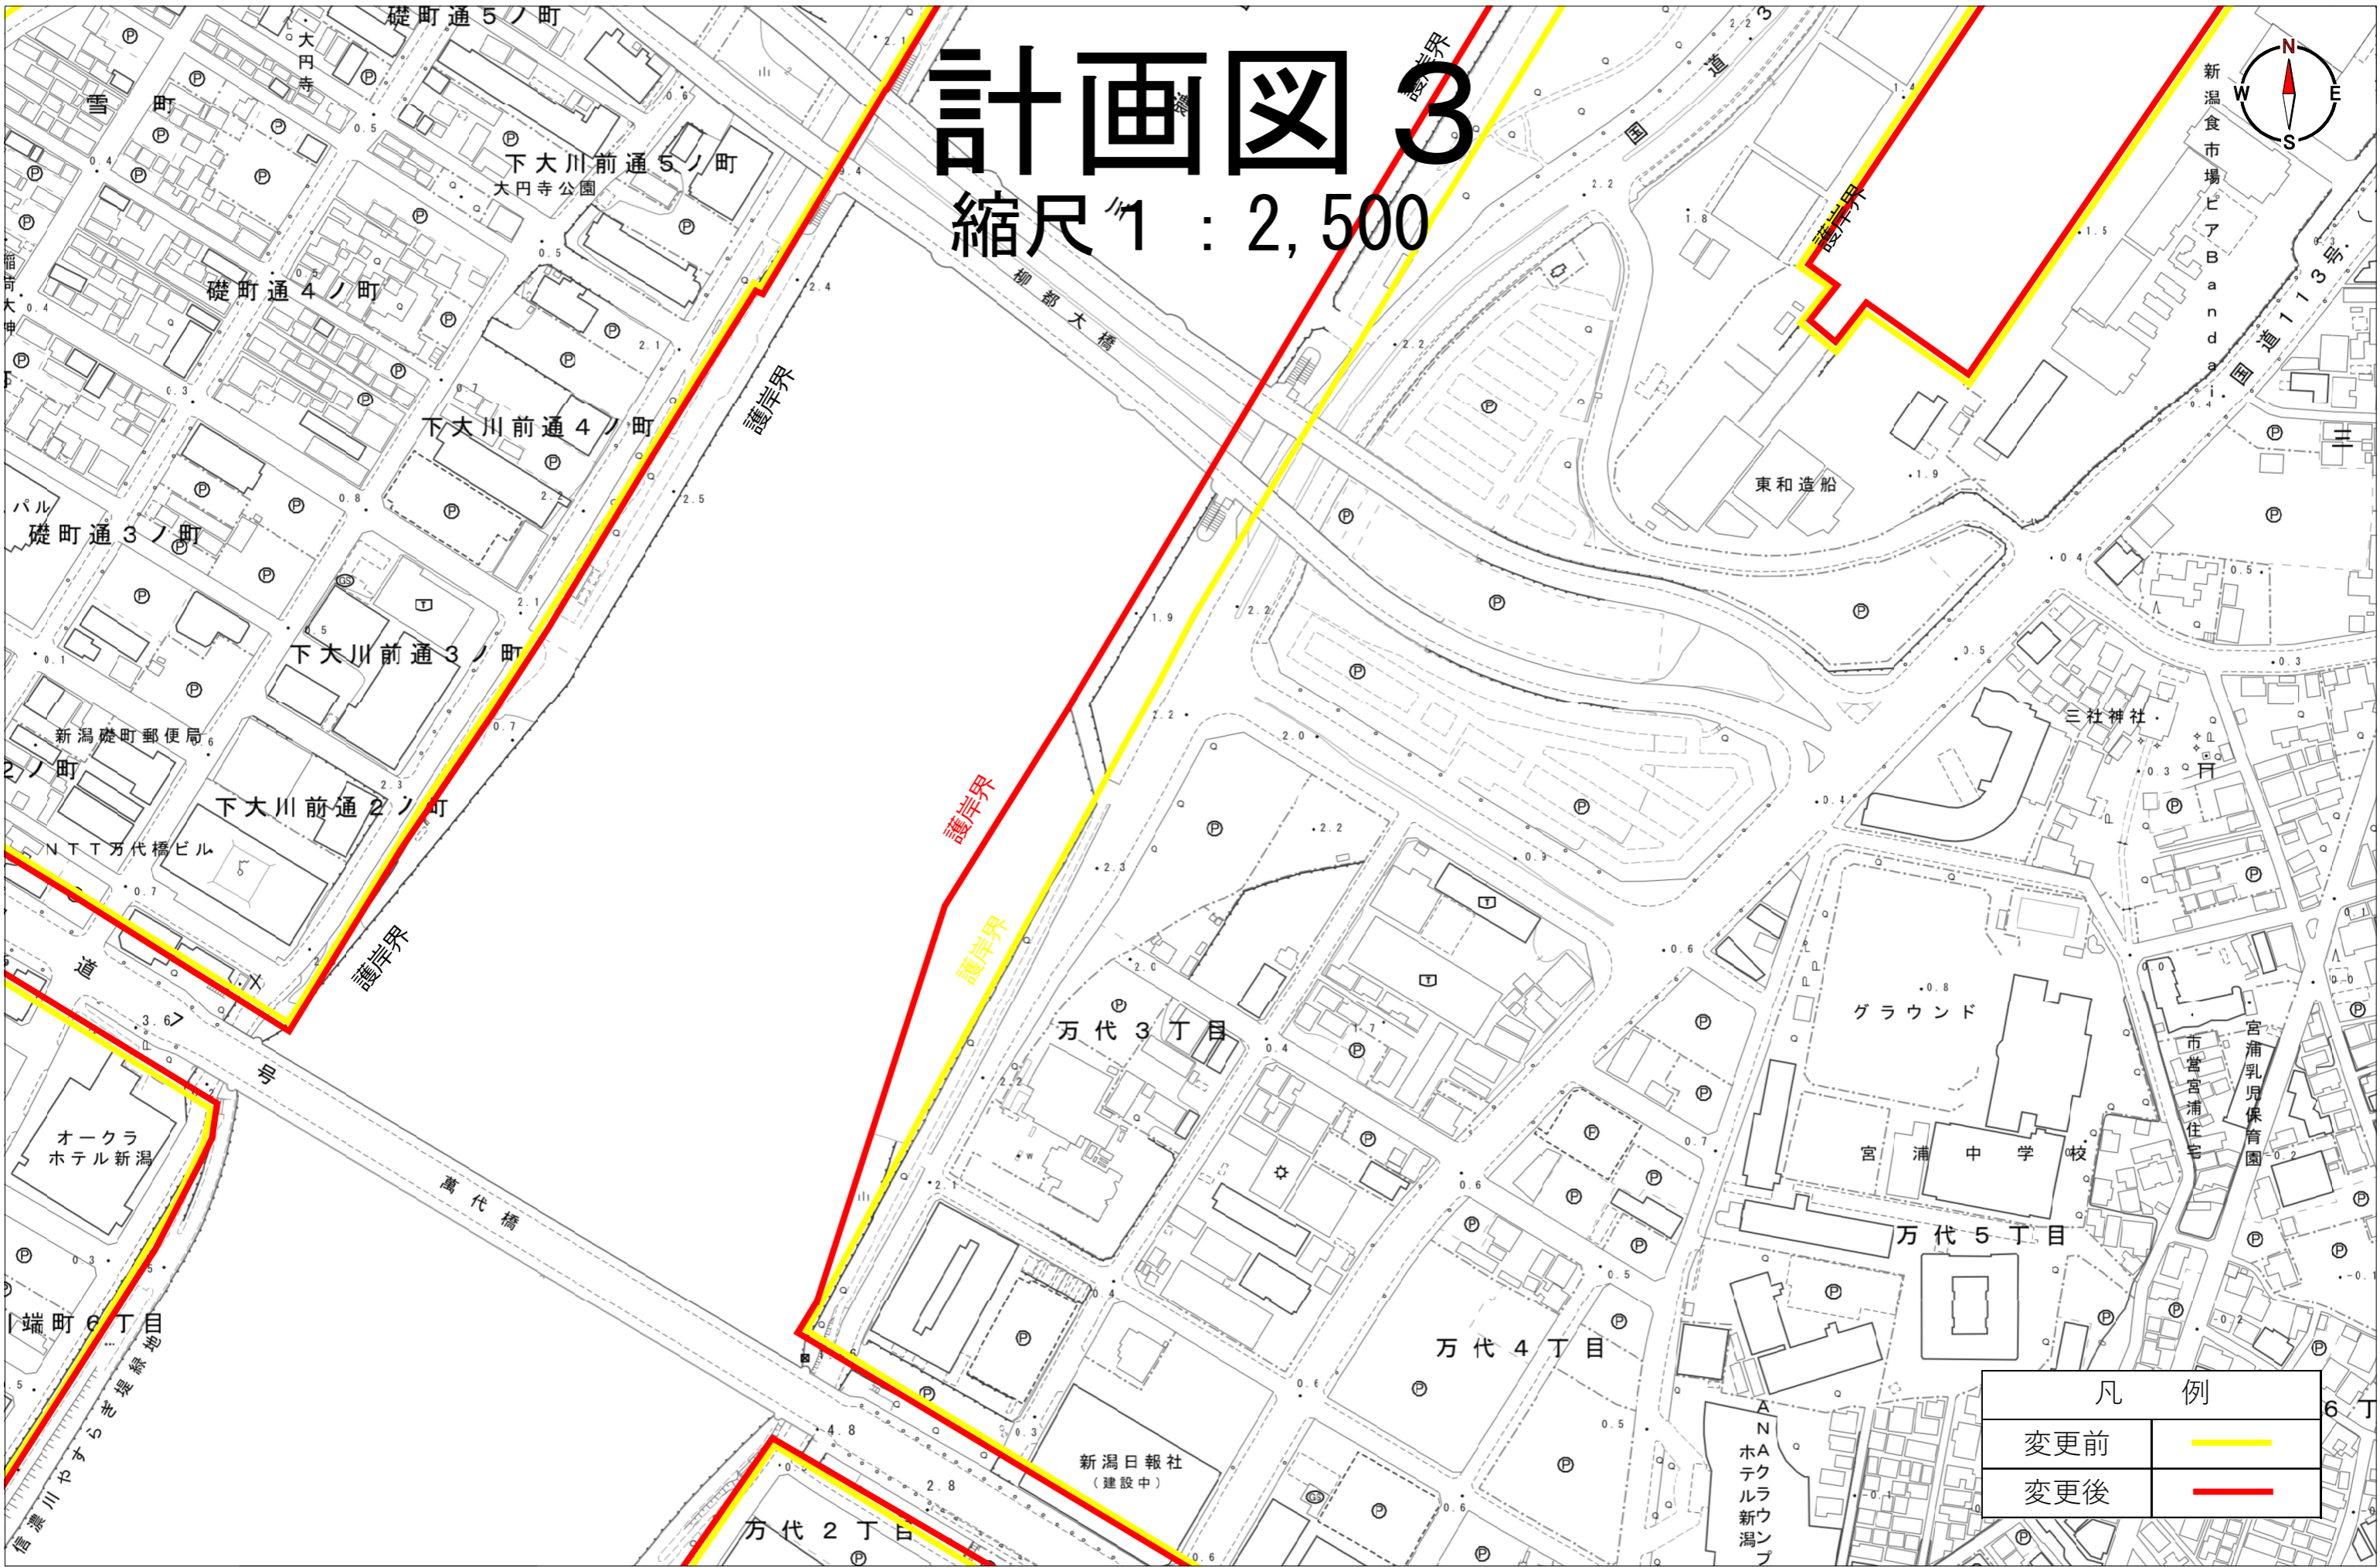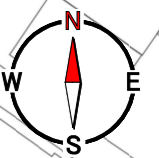

凡 例	
変更前	— (Yellow line)
変更後	— (Red line)

# 計画図 4

縮尺 1 : 2,500

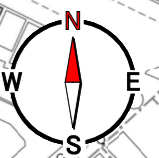

凡 例	
変更前	— (Yellow line)
変更後	— (Red line)