



# 計画図 1

縮尺 1 : 2,500

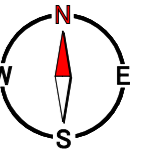


凡 例	
変更前	— (Yellow line)
変更後	— (Red line)

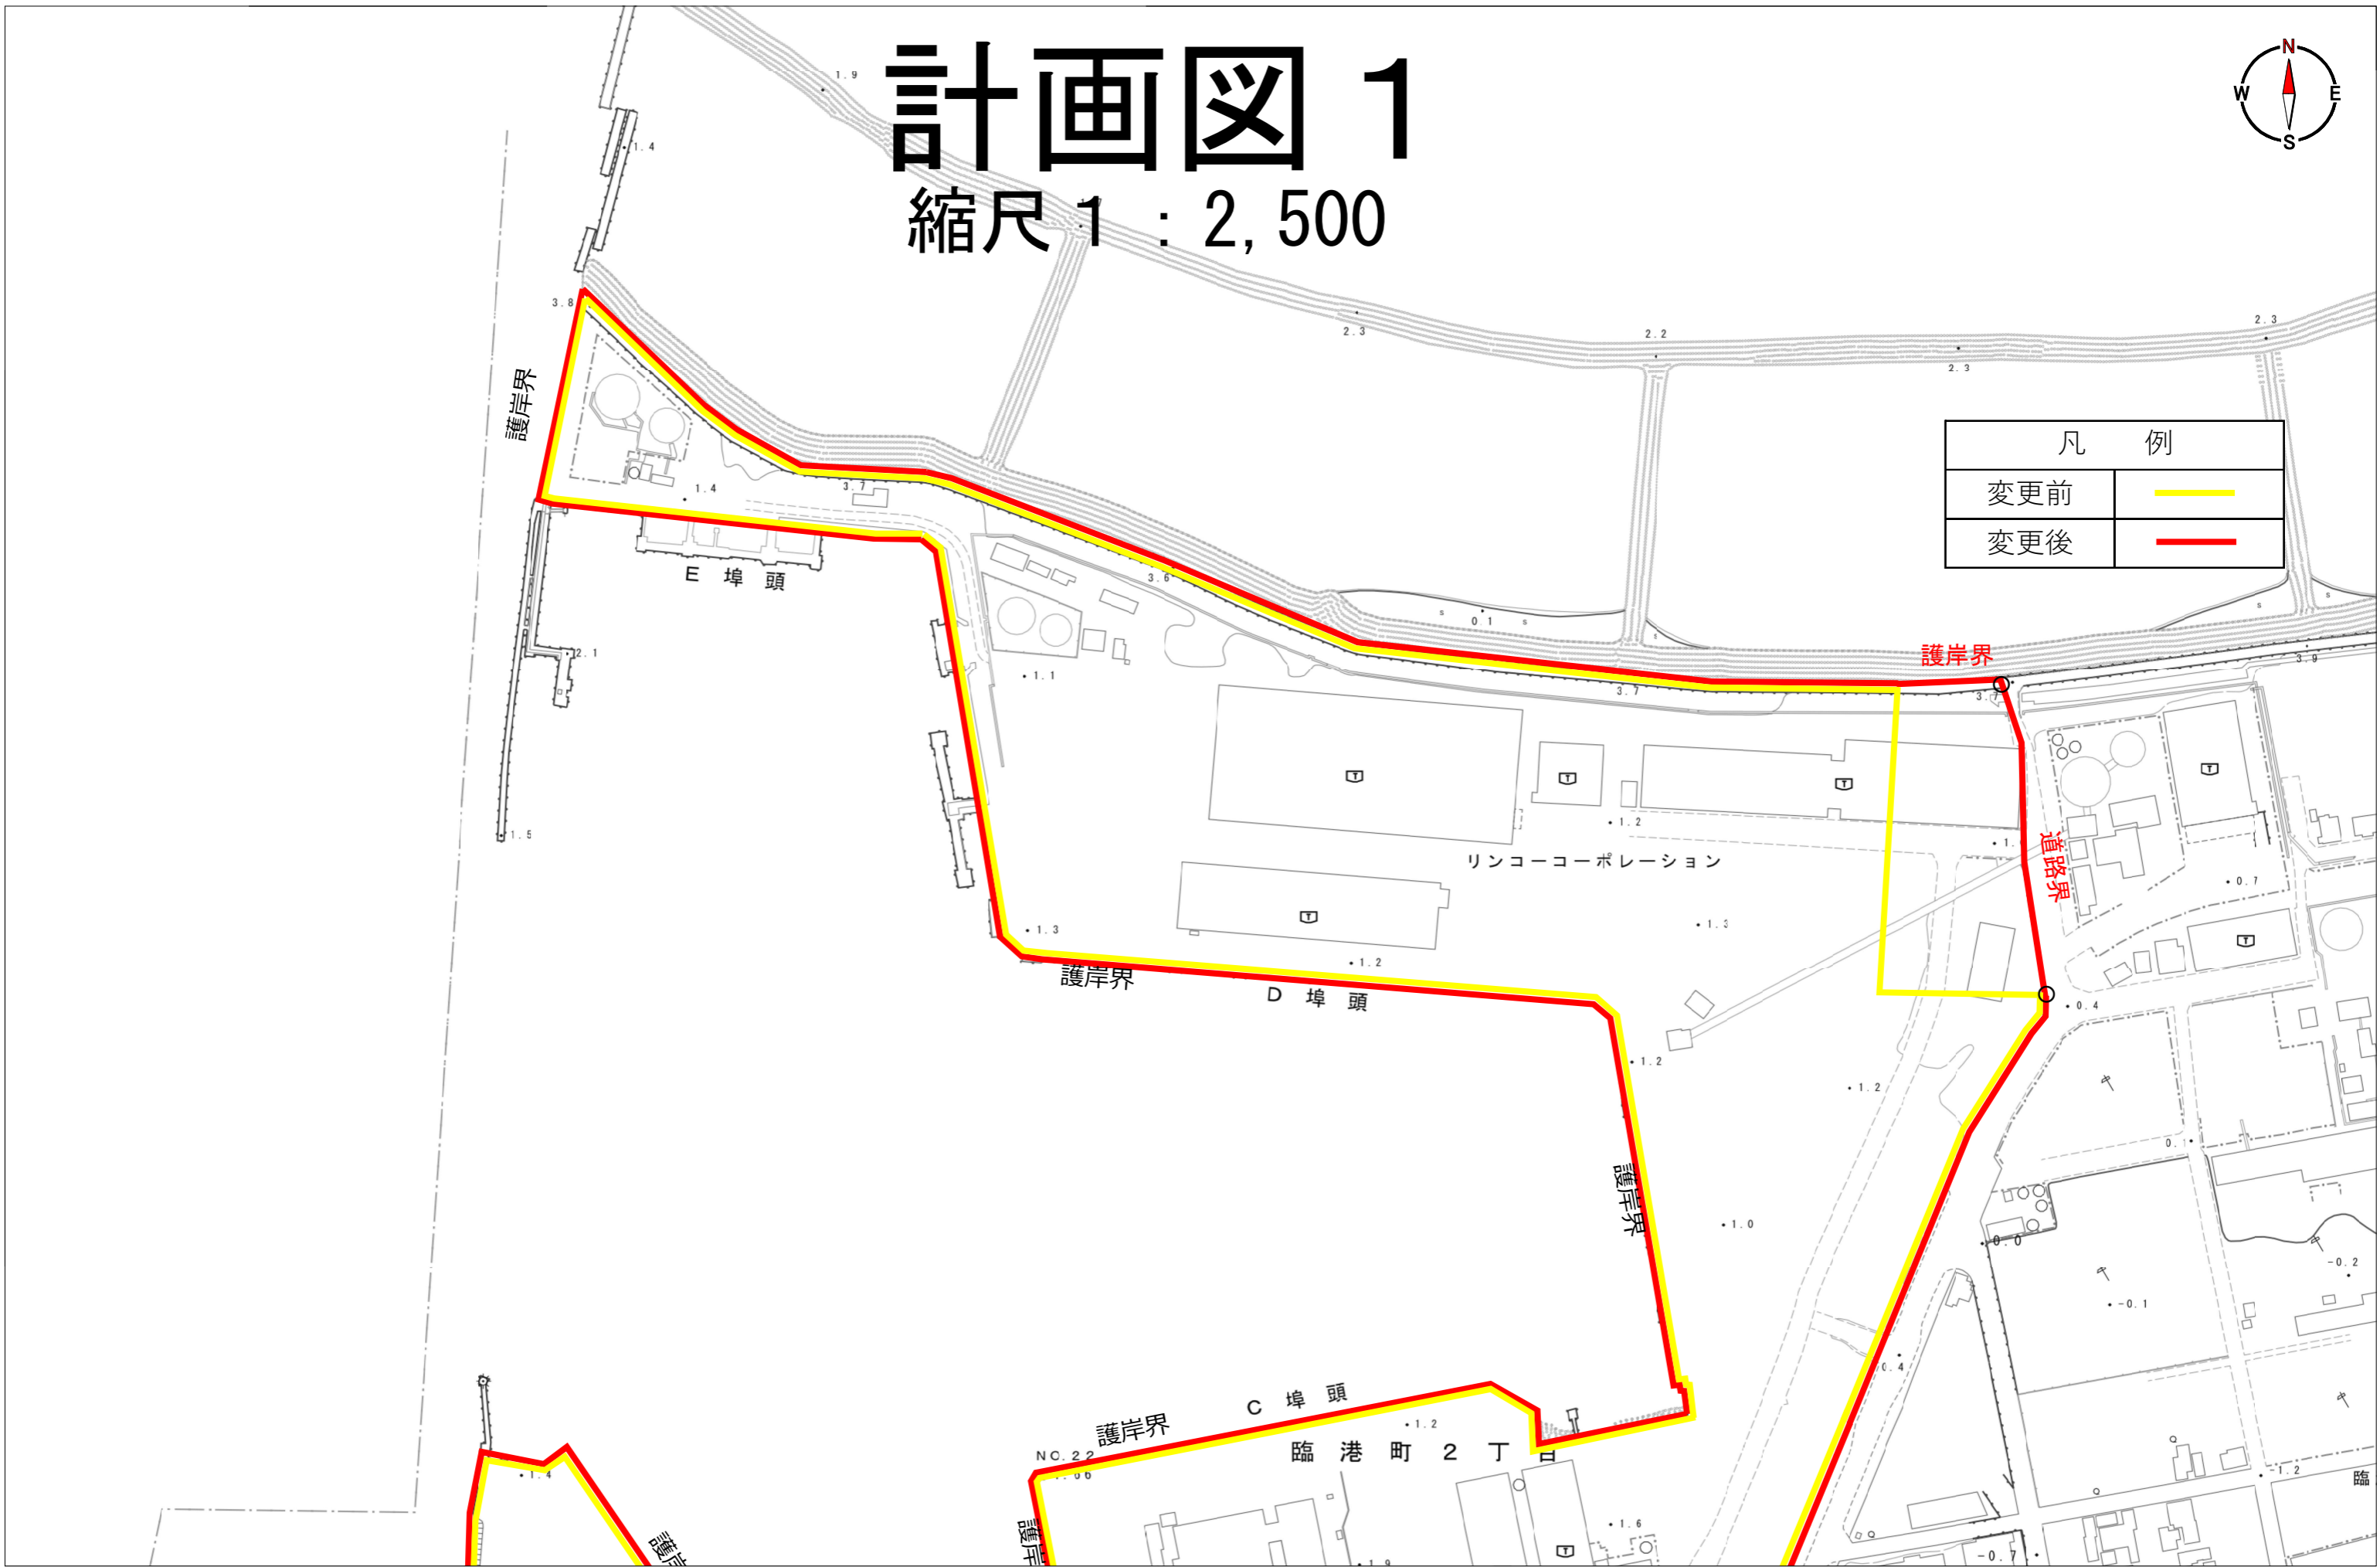




# 計画図3

縮尺 1 : 2,500

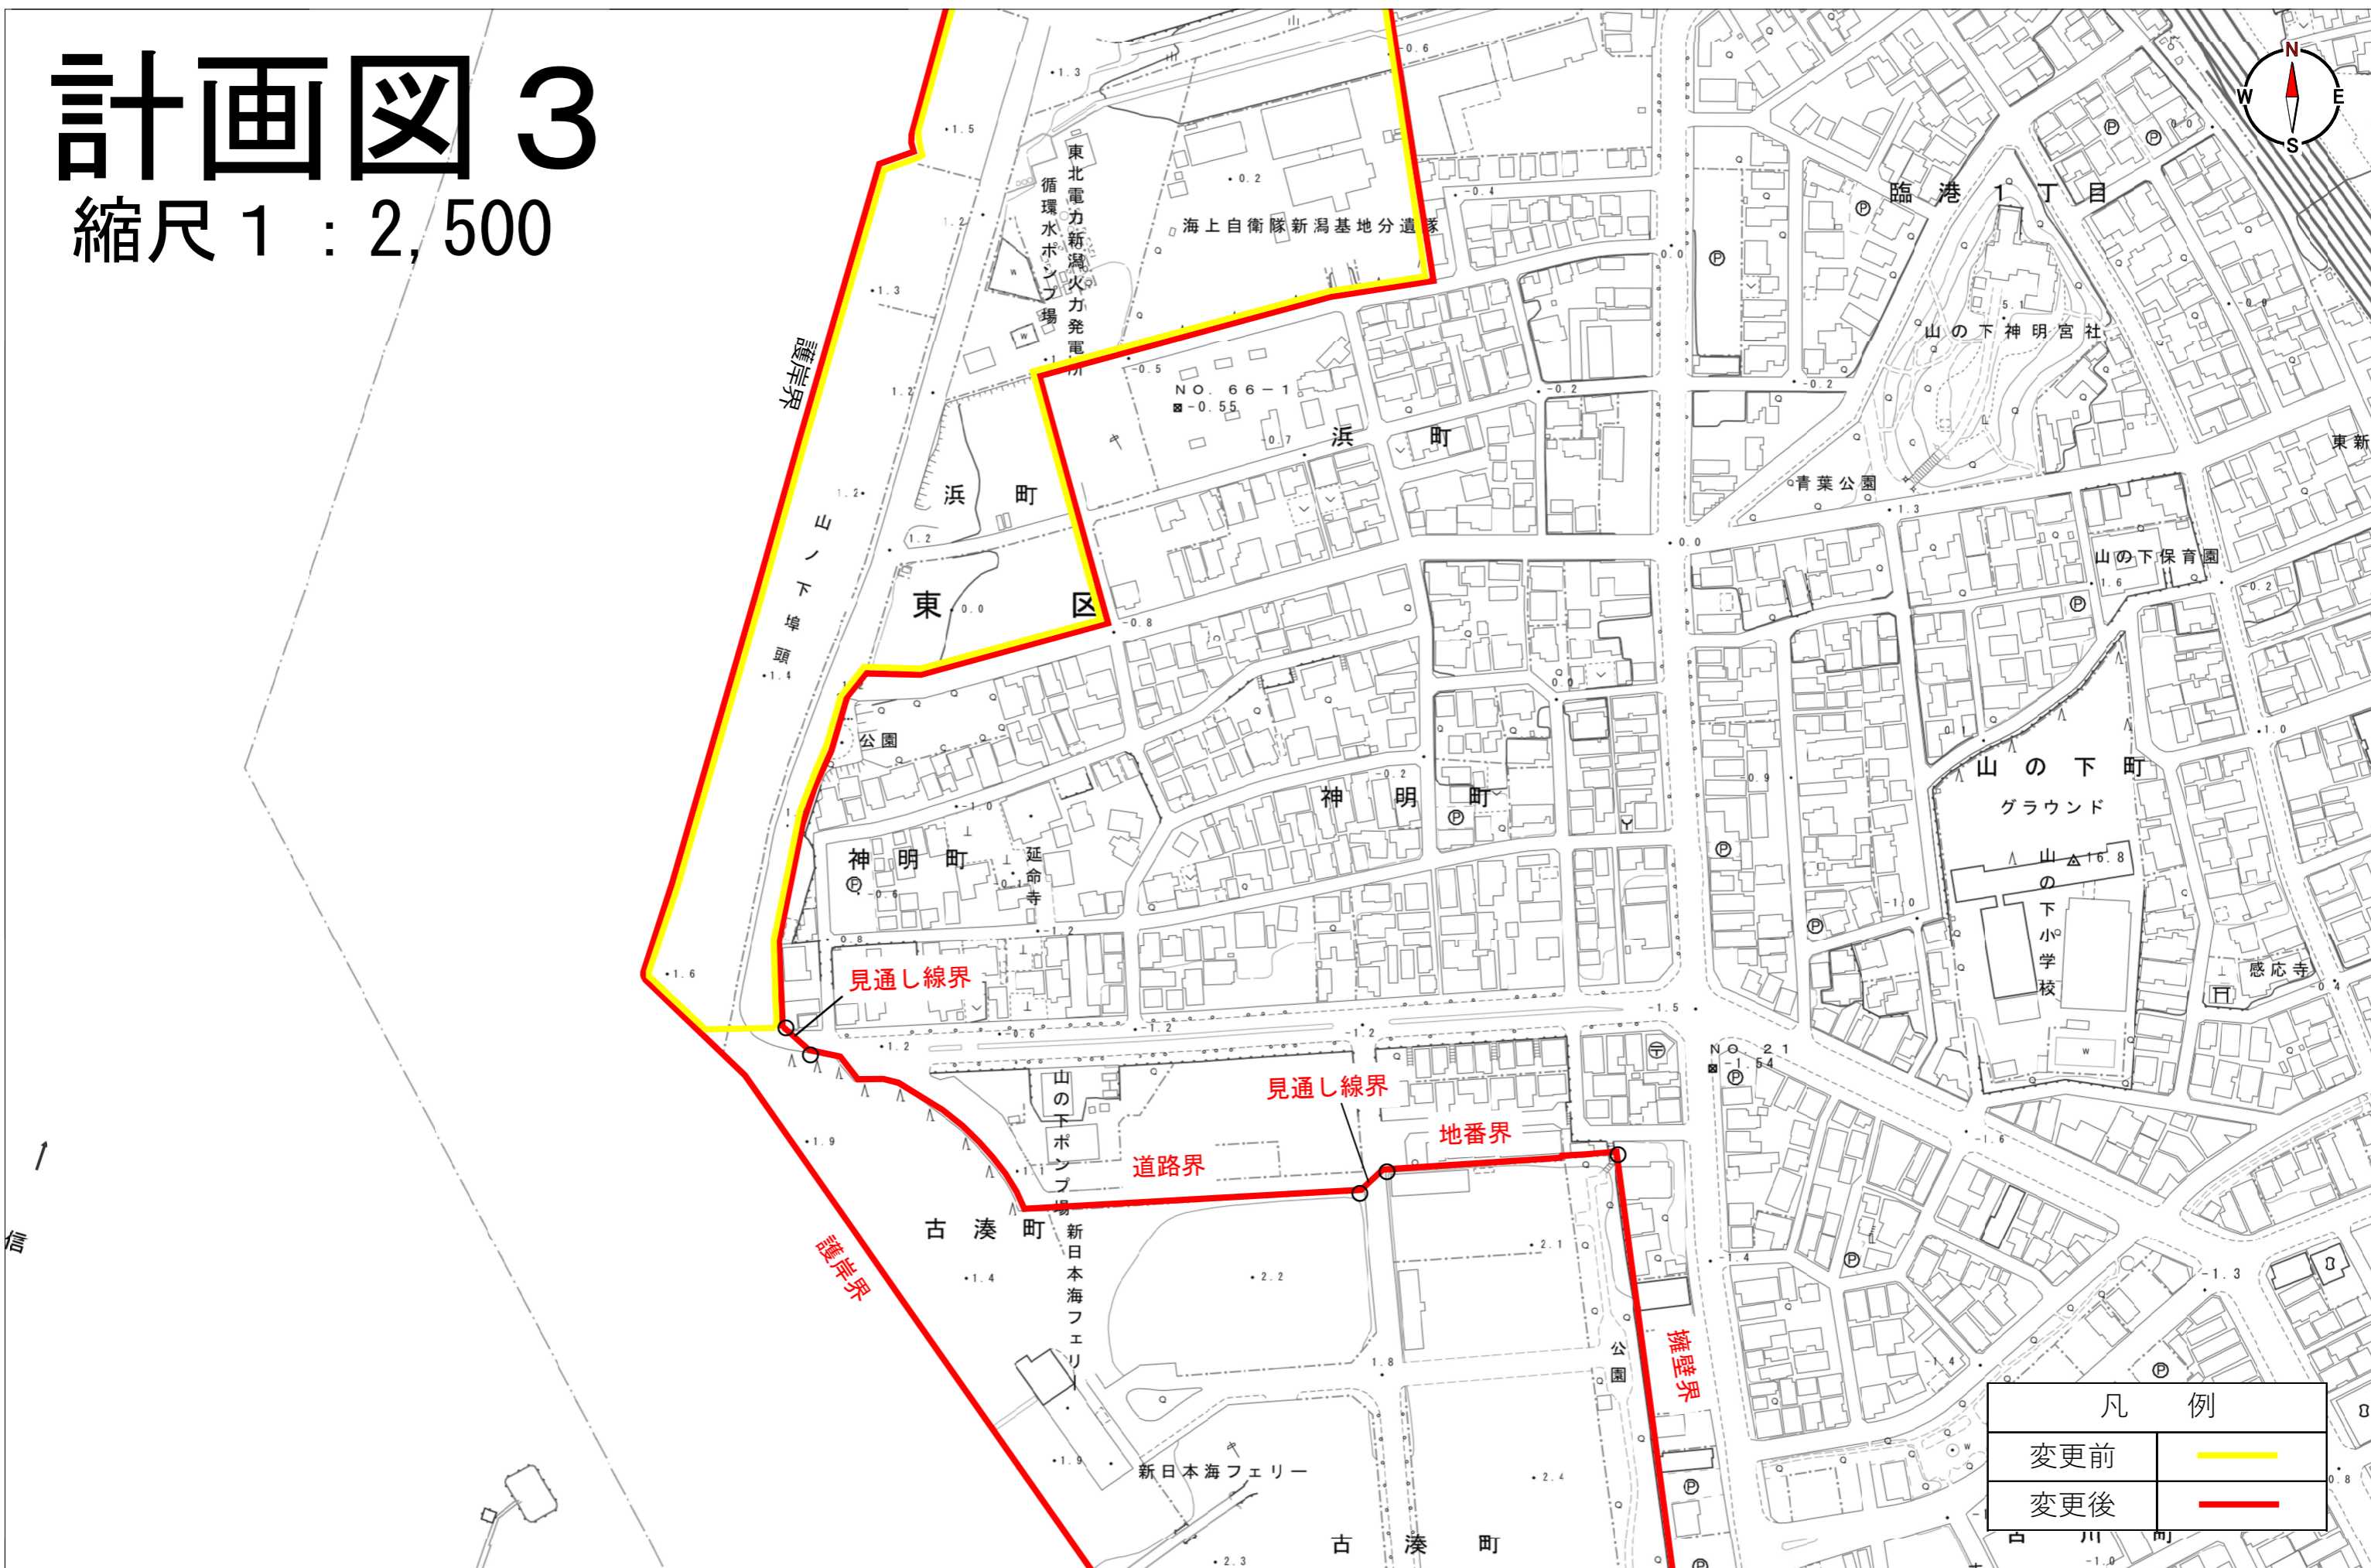


# 計画図4

縮尺 1 : 2,500

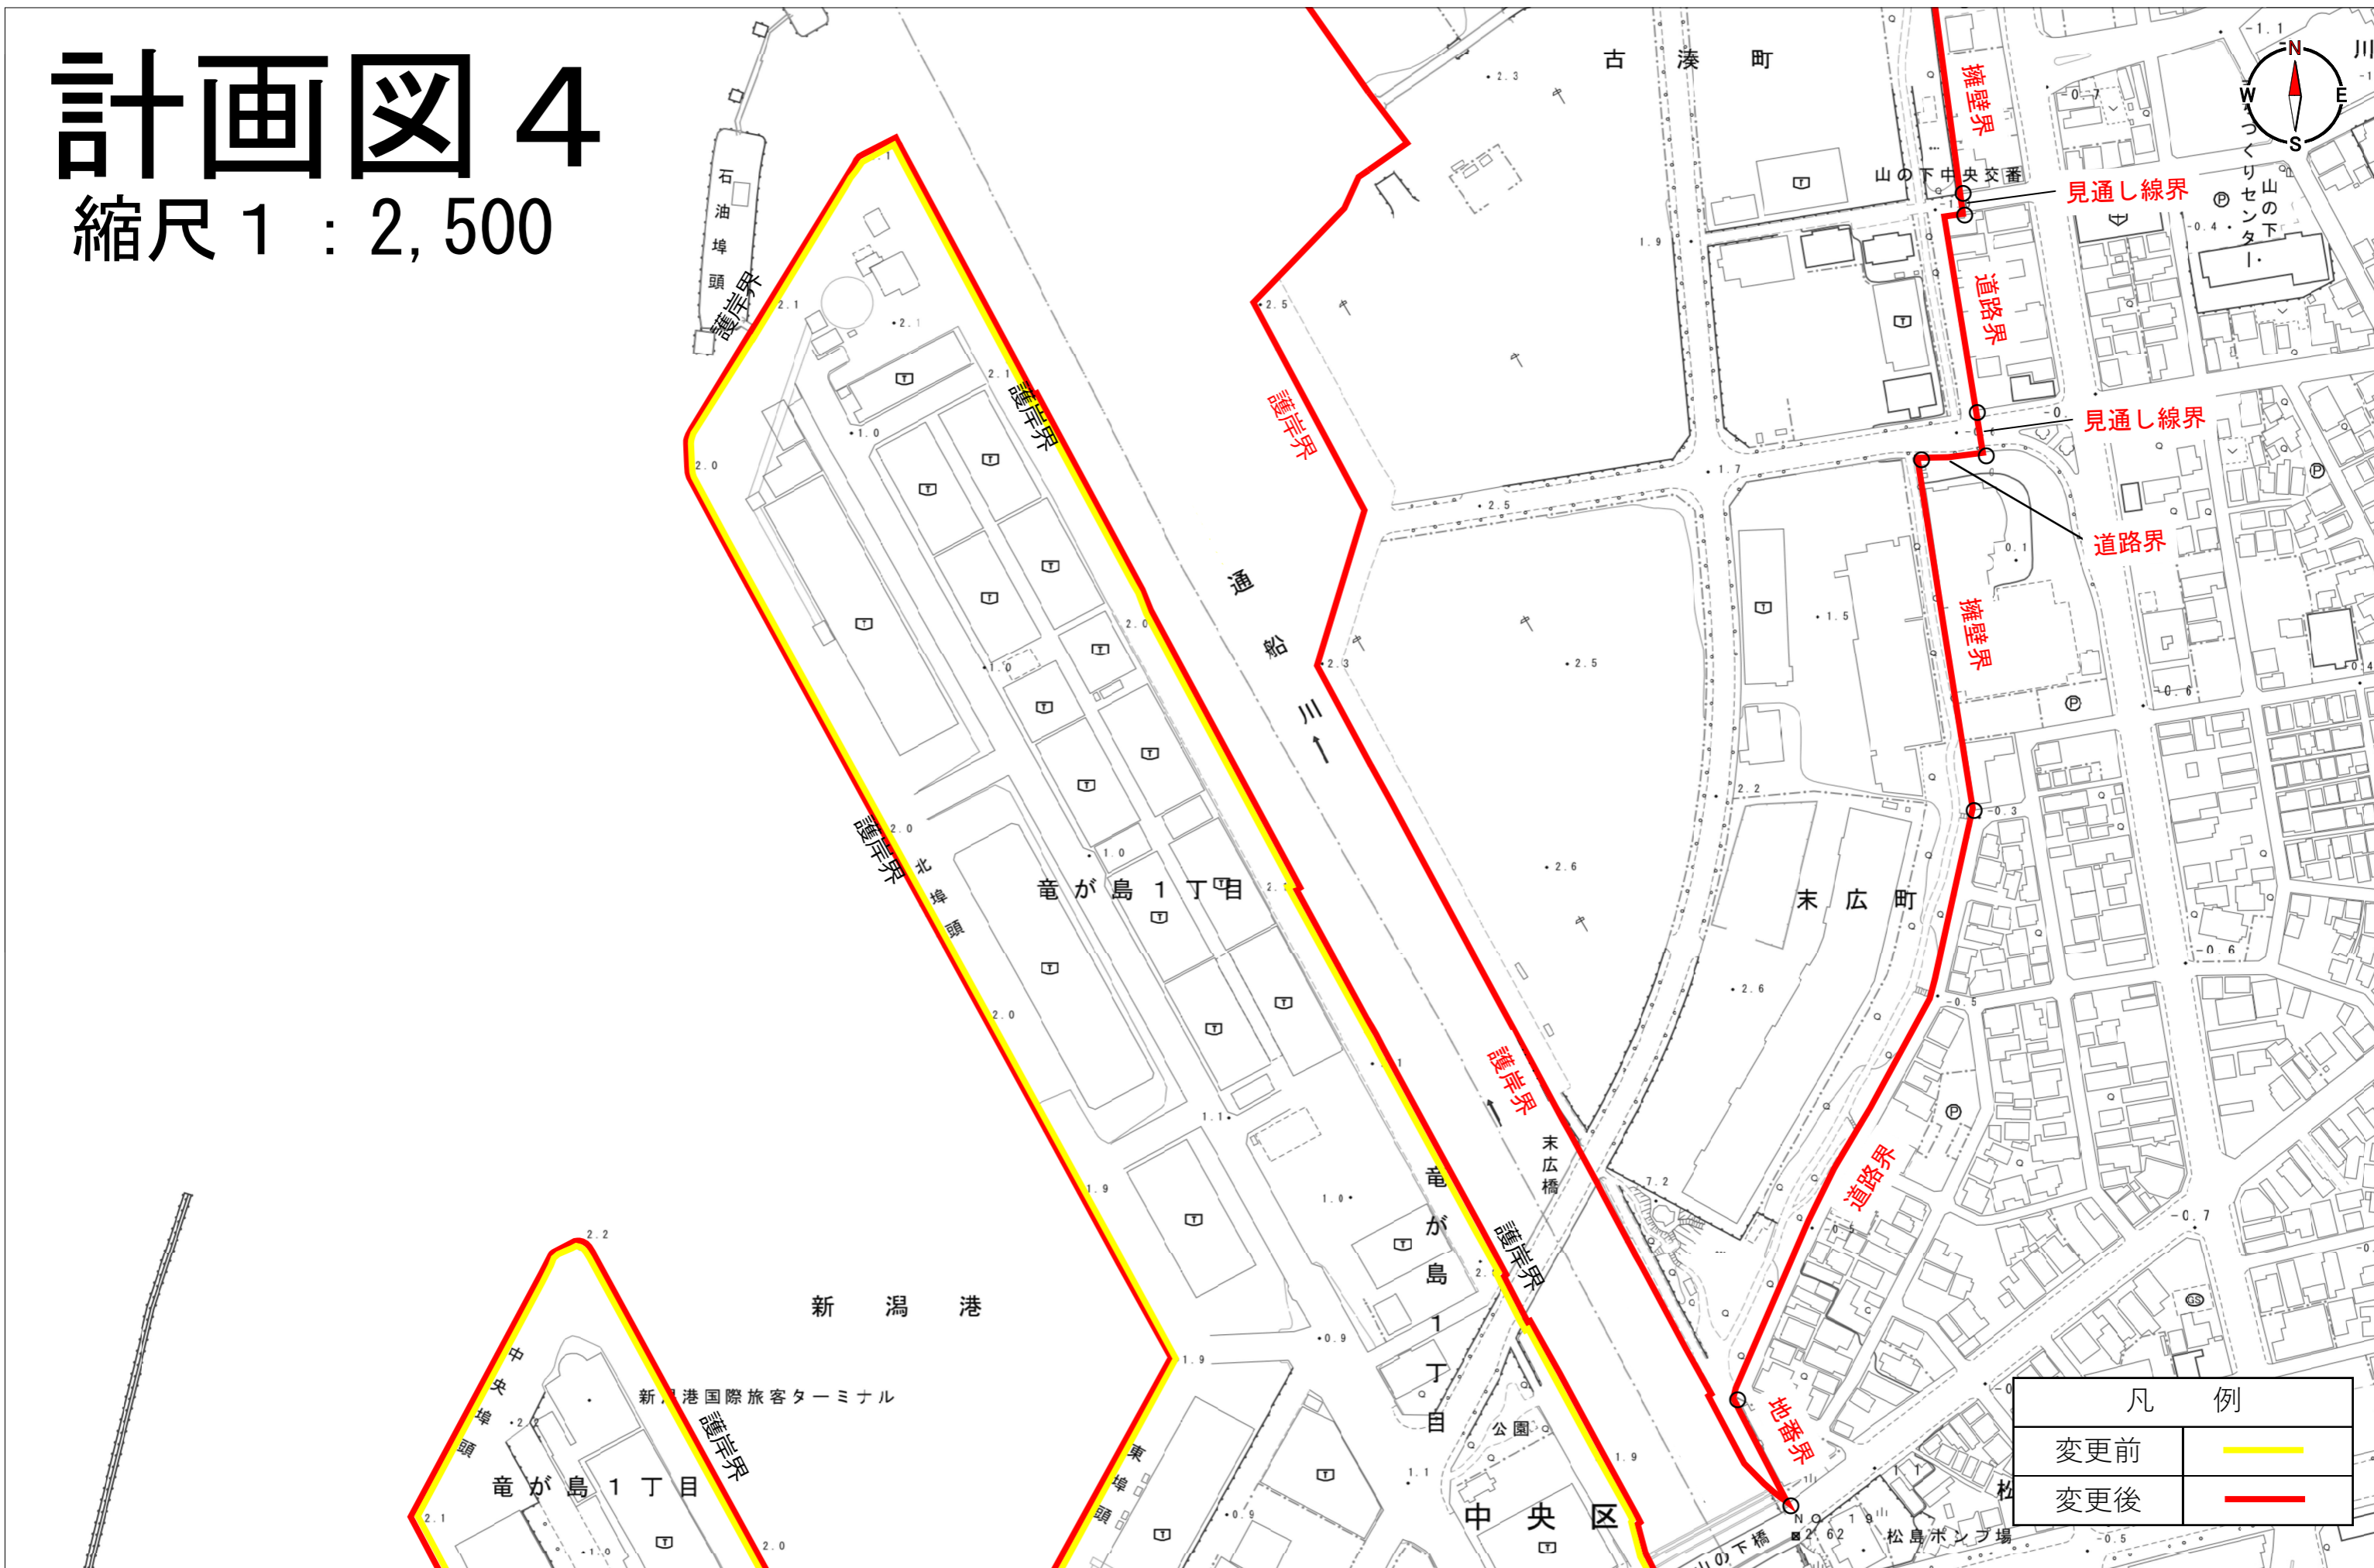

# 計画図5


縮尺 1 : 2,500

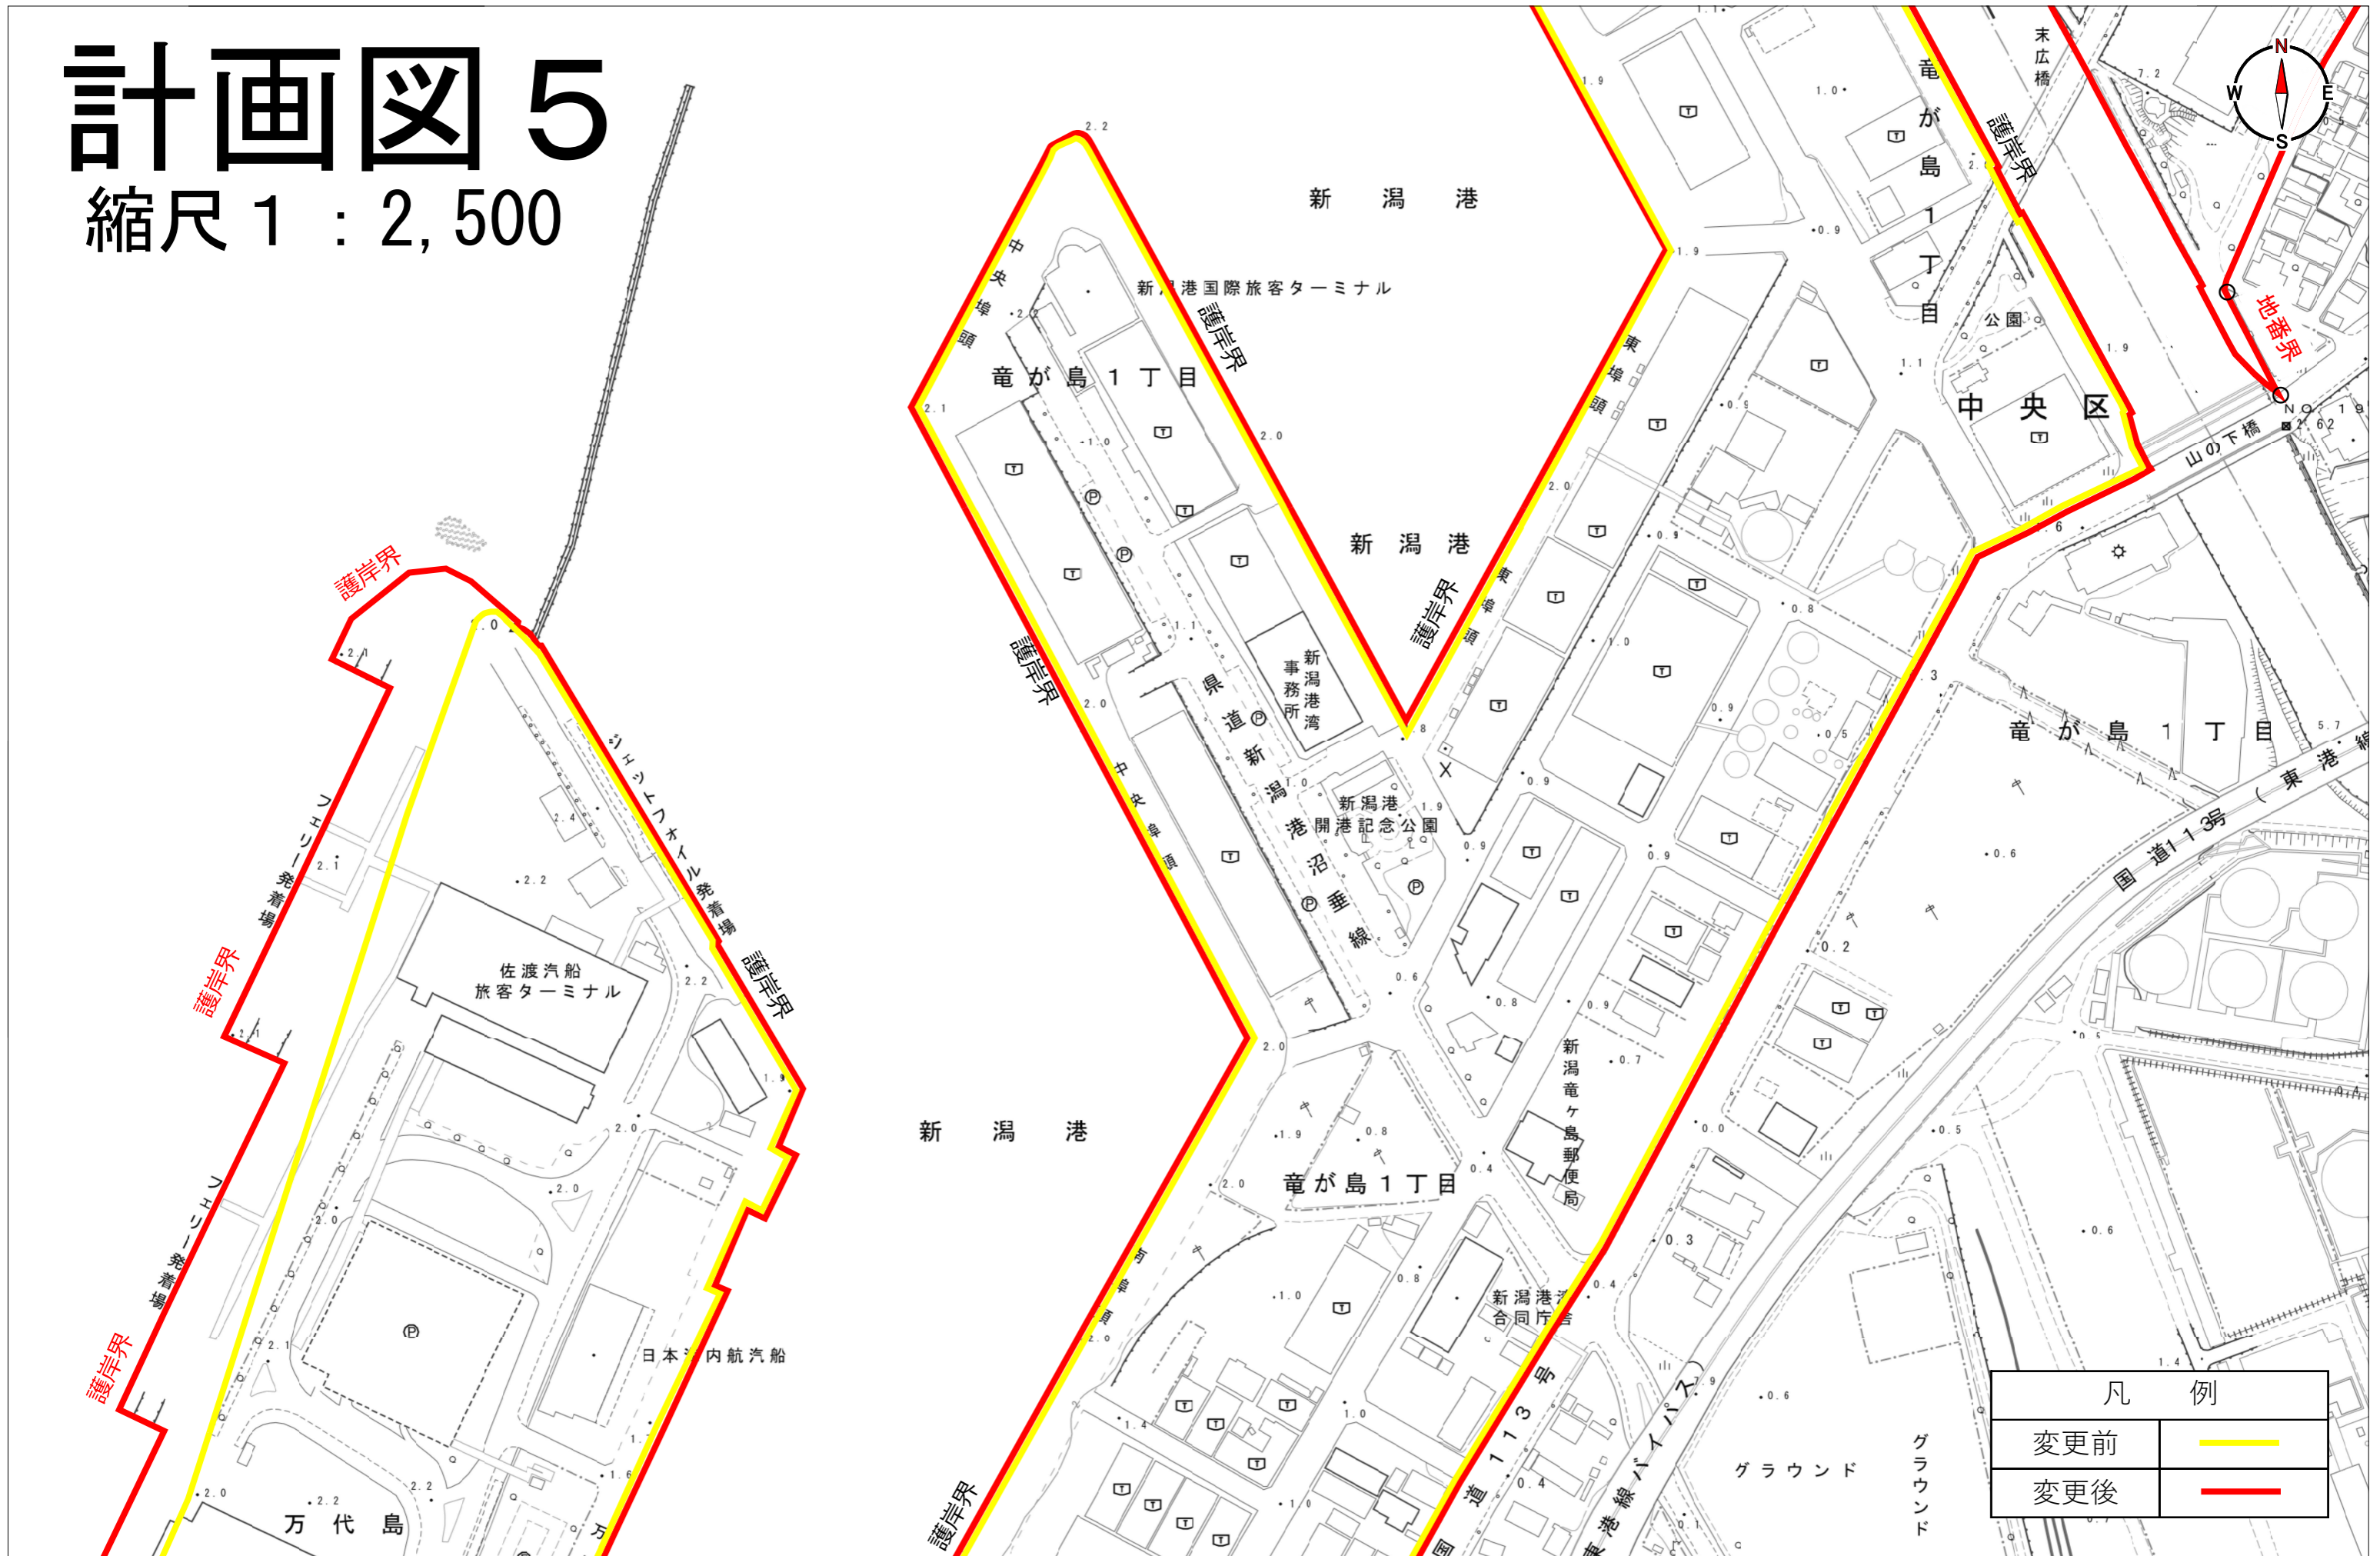

凡例	
変更前	— (Yellow line)
変更後	— (Red line)

# 計画図6



縮尺 1 : 2,500

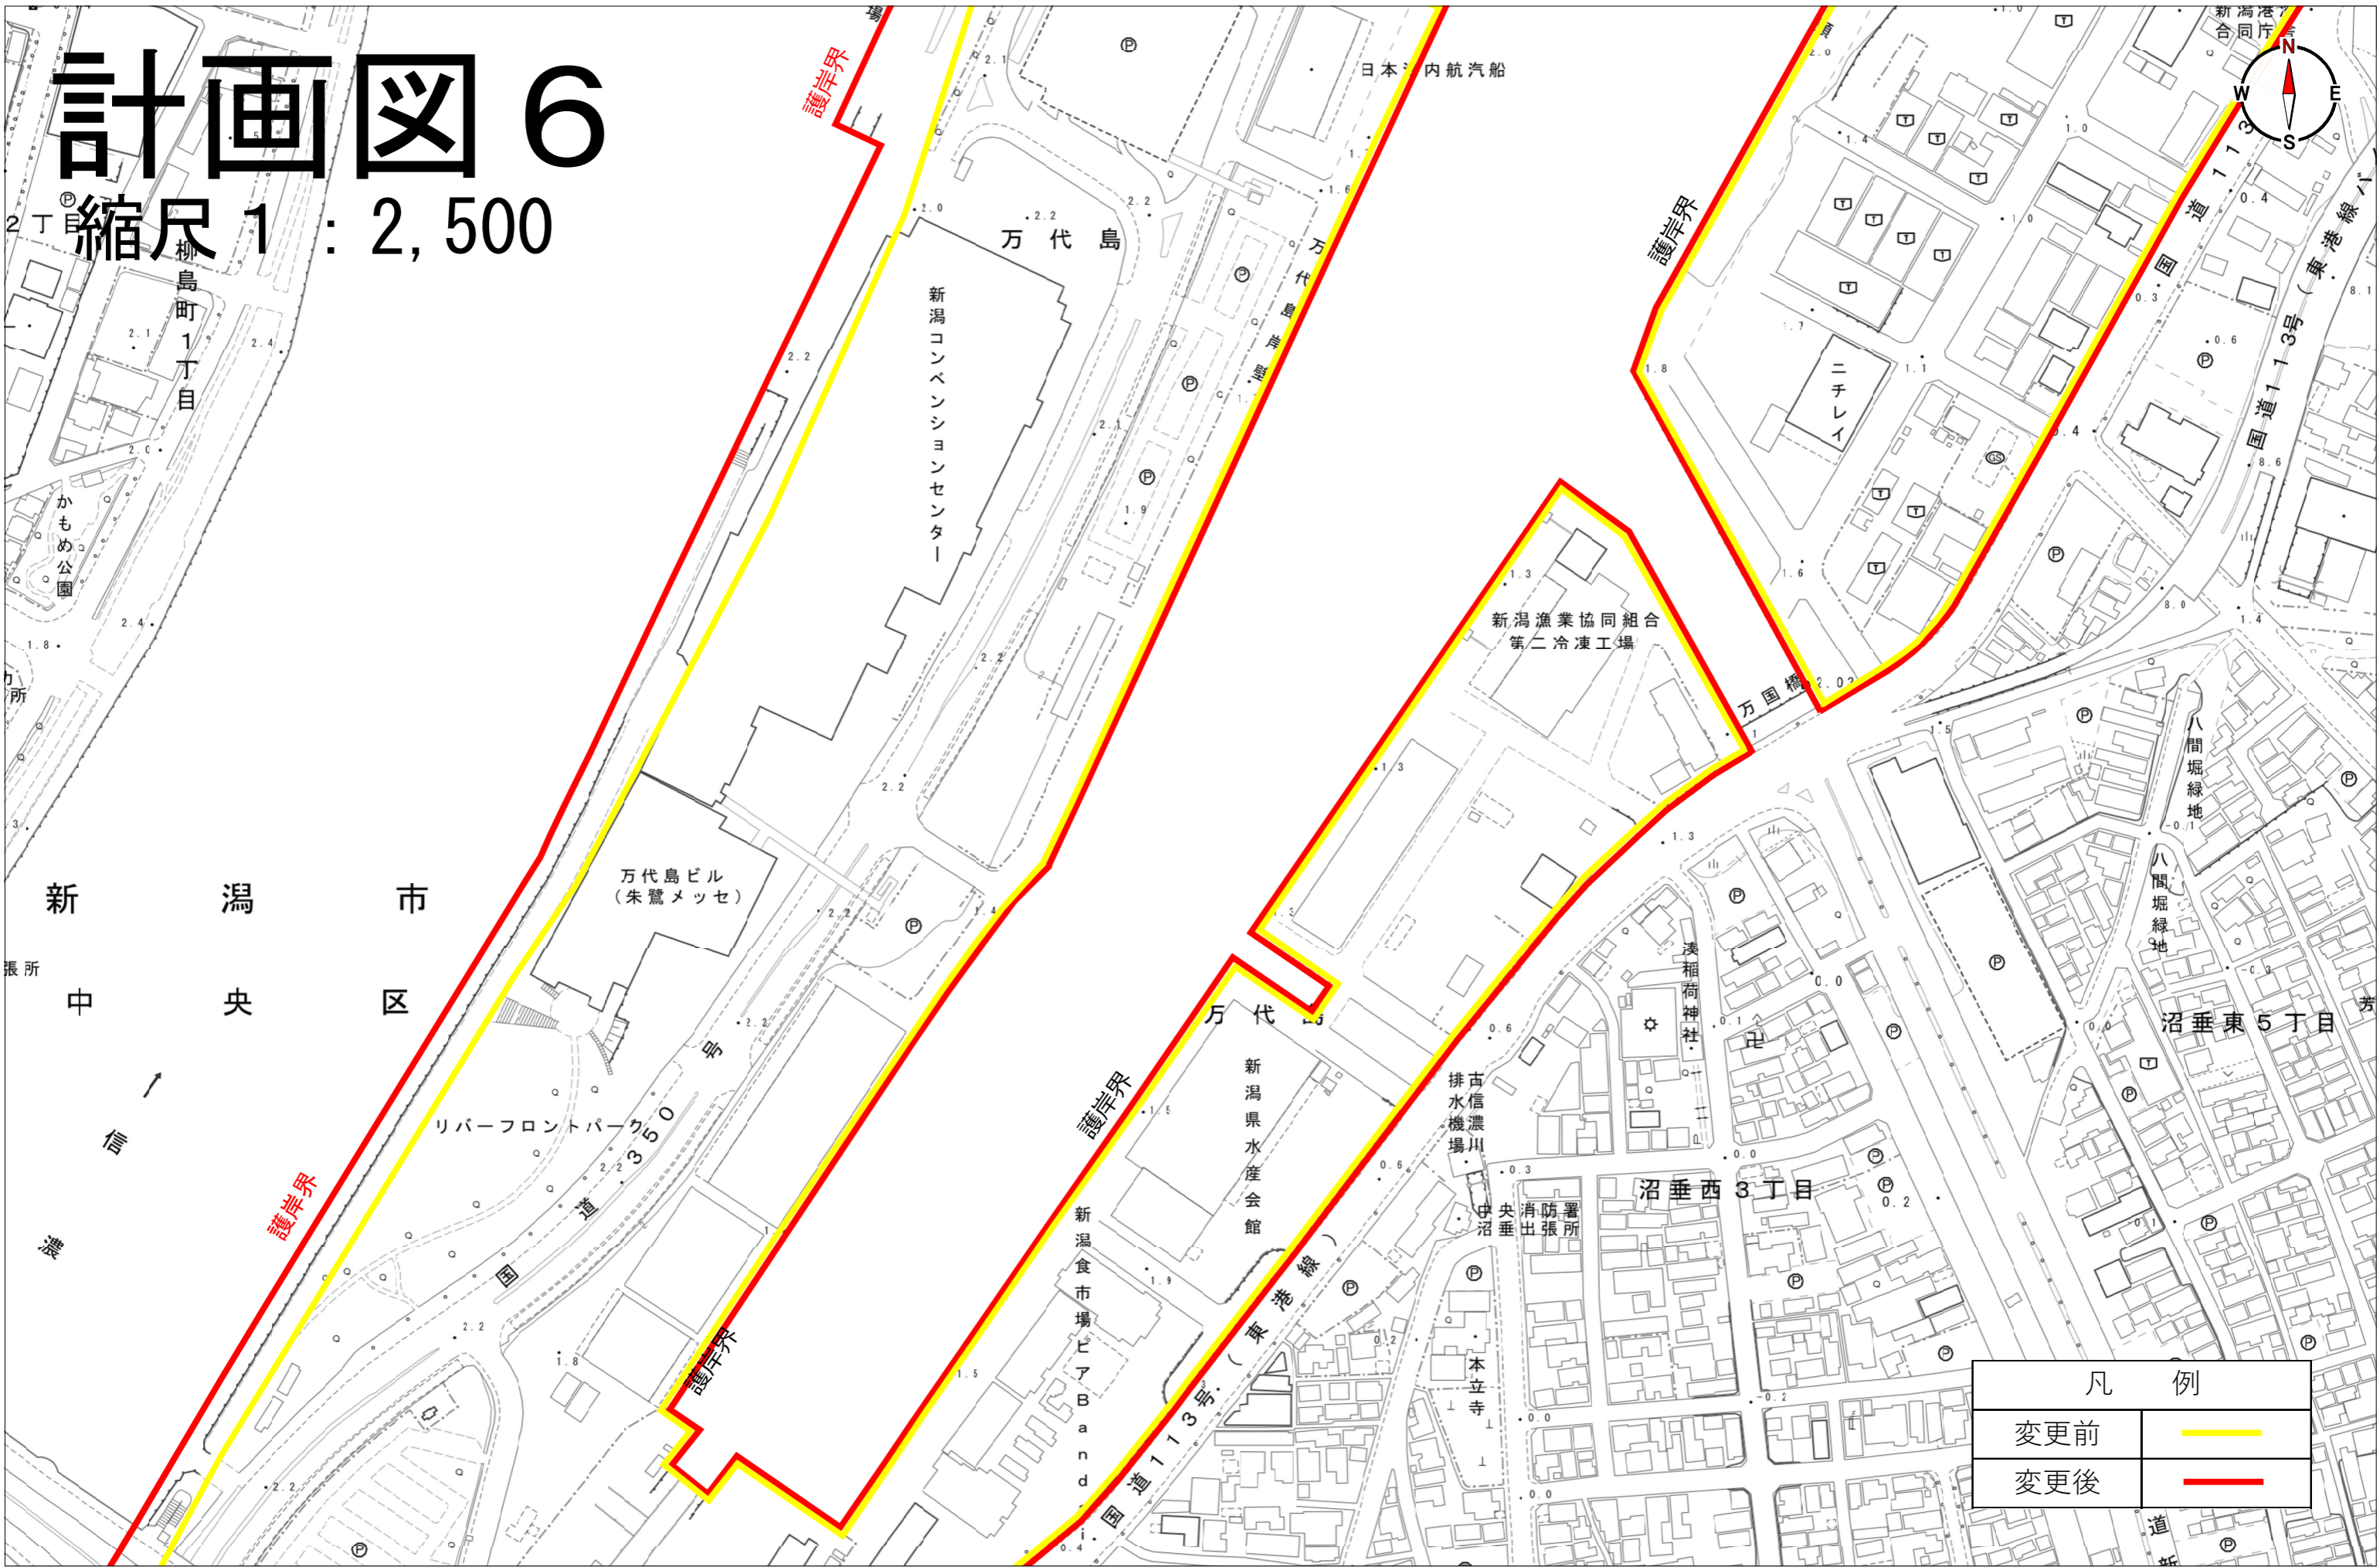

凡例	
変更前	
変更後	

# 計画図7

縮尺 1 : 2,500

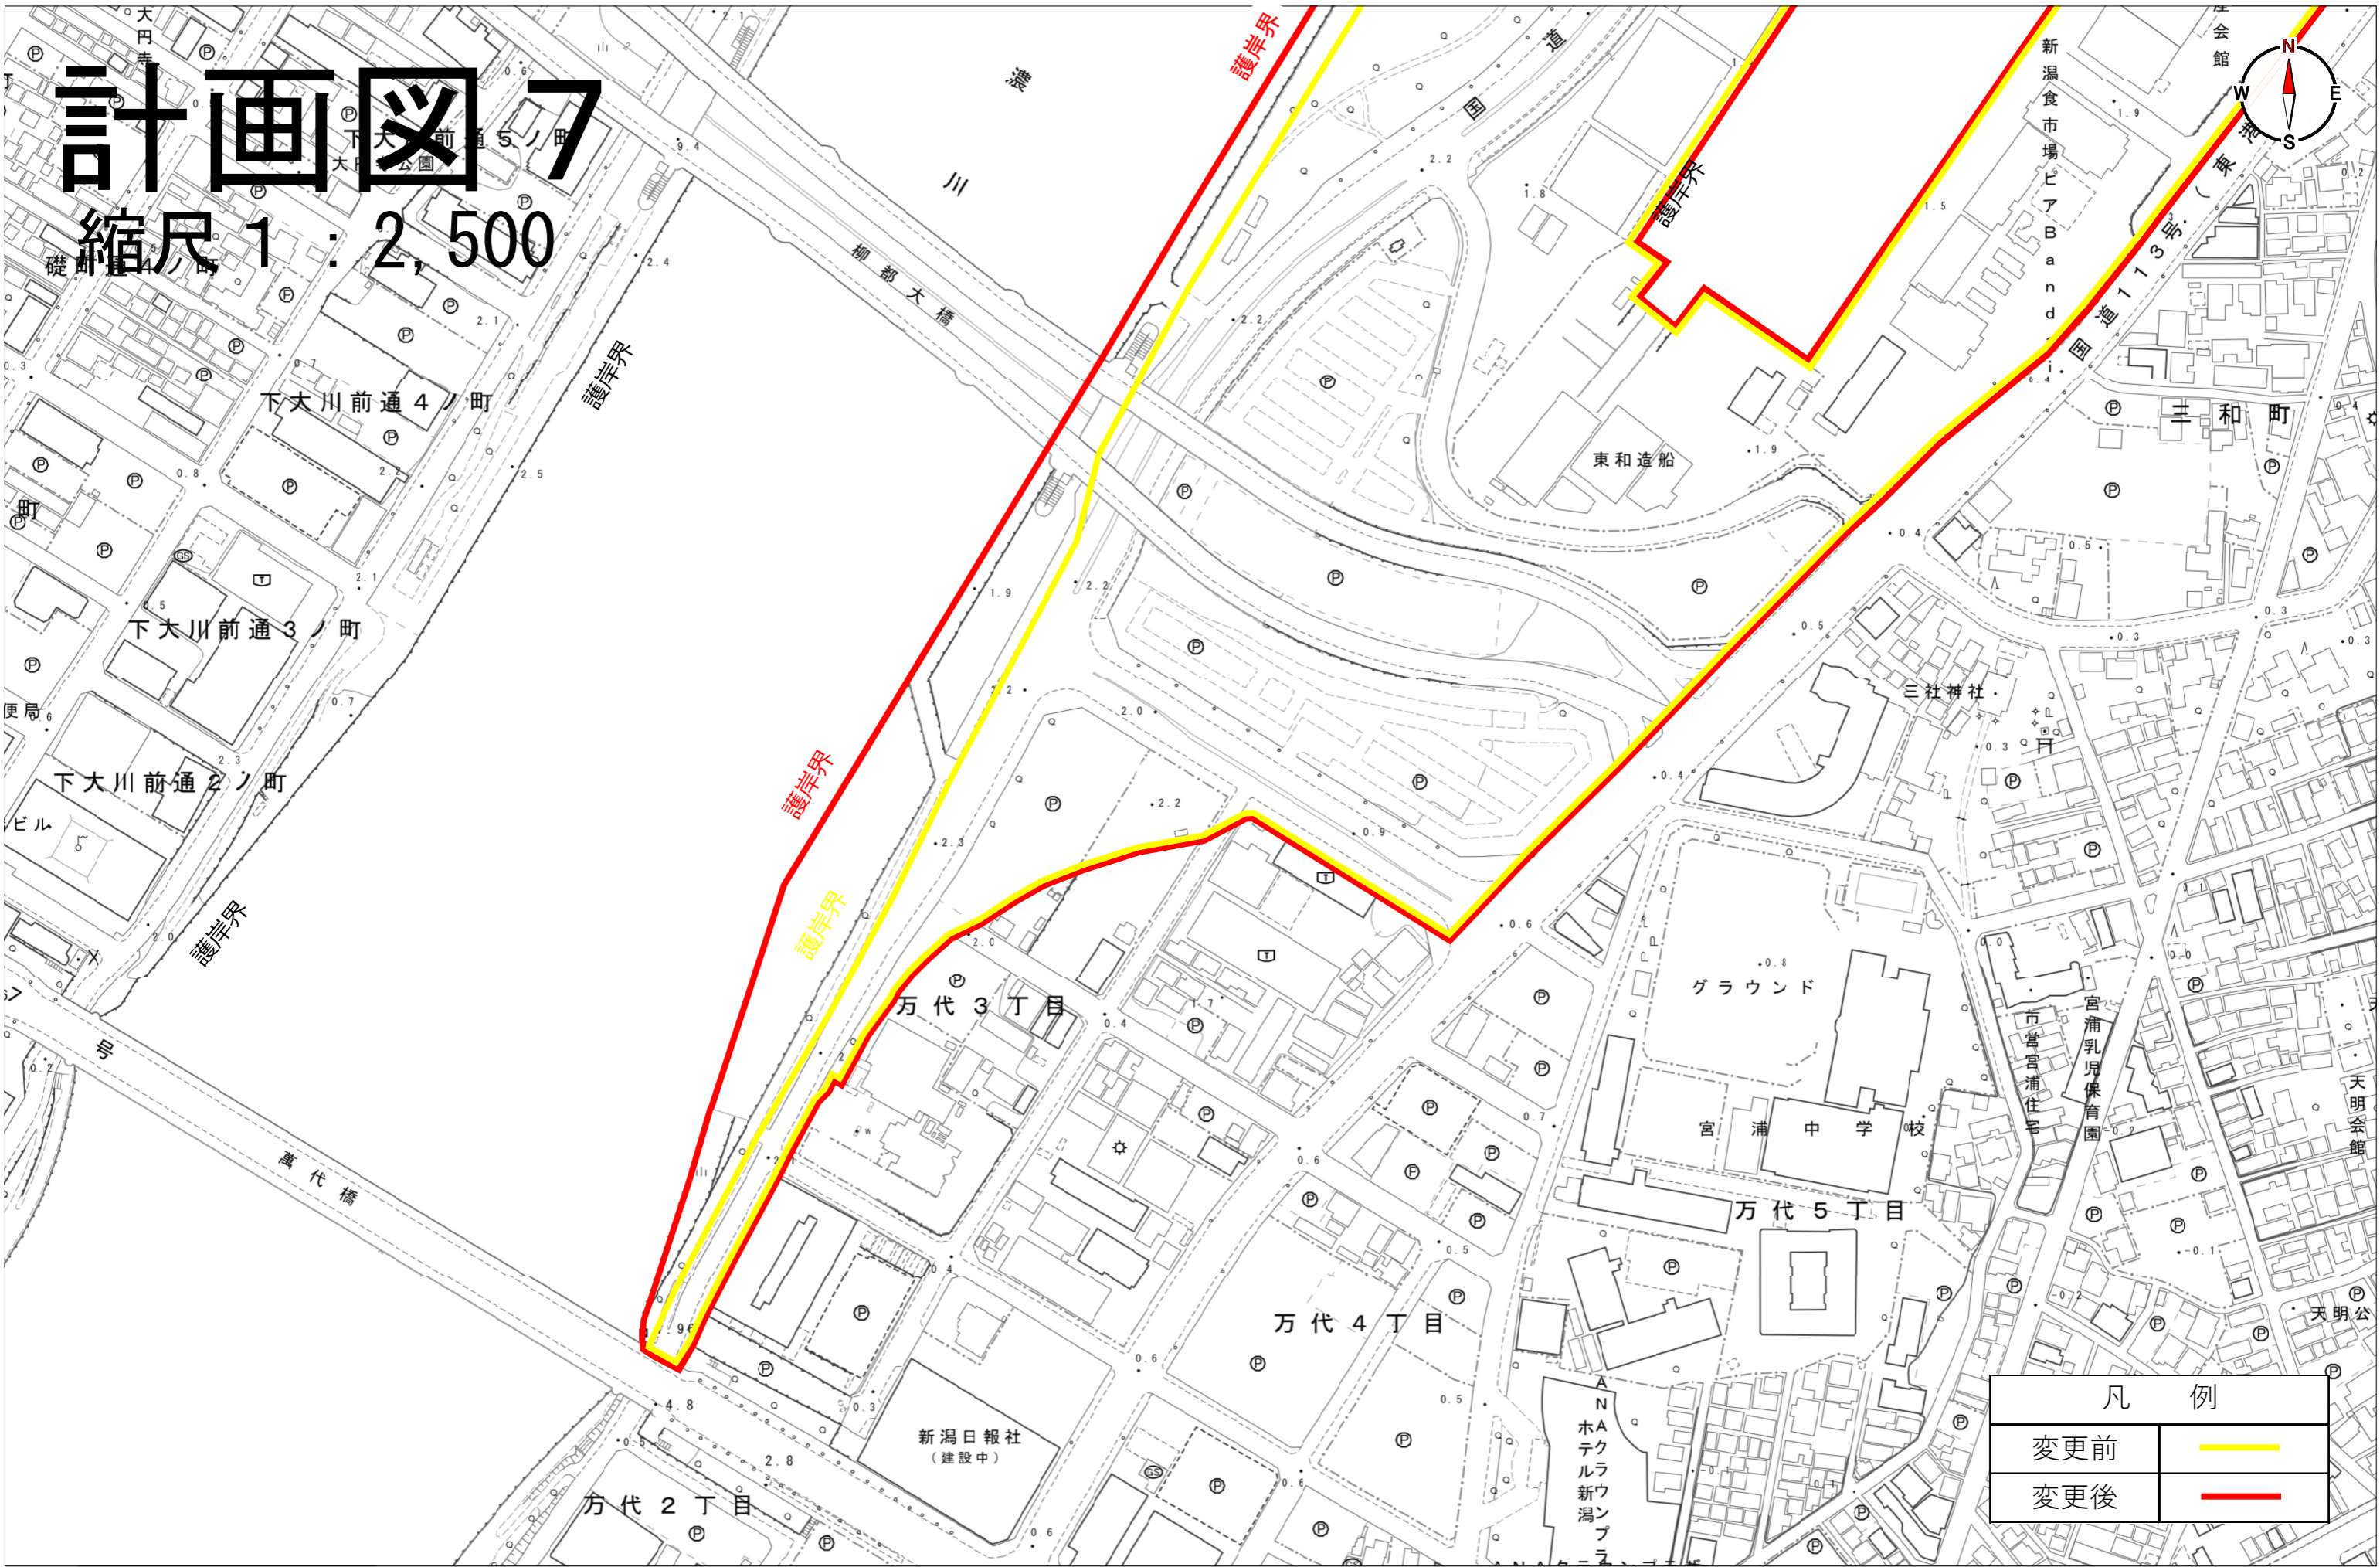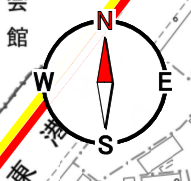

凡例	
変更前	— (Yellow line)
変更後	— (Red line)